


713000

ABANDONED 29 1/2" OF 54" STEEL PIPE FROM LIFT STATION
 PROT. # 72-052B TO JUNCTION STRUCTURE #1 ON SOUTH
 SIDE OF SOUTH PLATTE RIVER 8/31/00 - HB.

712000
 ABANDONED 1,244.05' OF SEWER LINE FROM
 GATE STRUCTURE ON FRANKLIN ST. AND PLATTE
 RIVER, WEST TO JUNCTION STRUCTURE #1

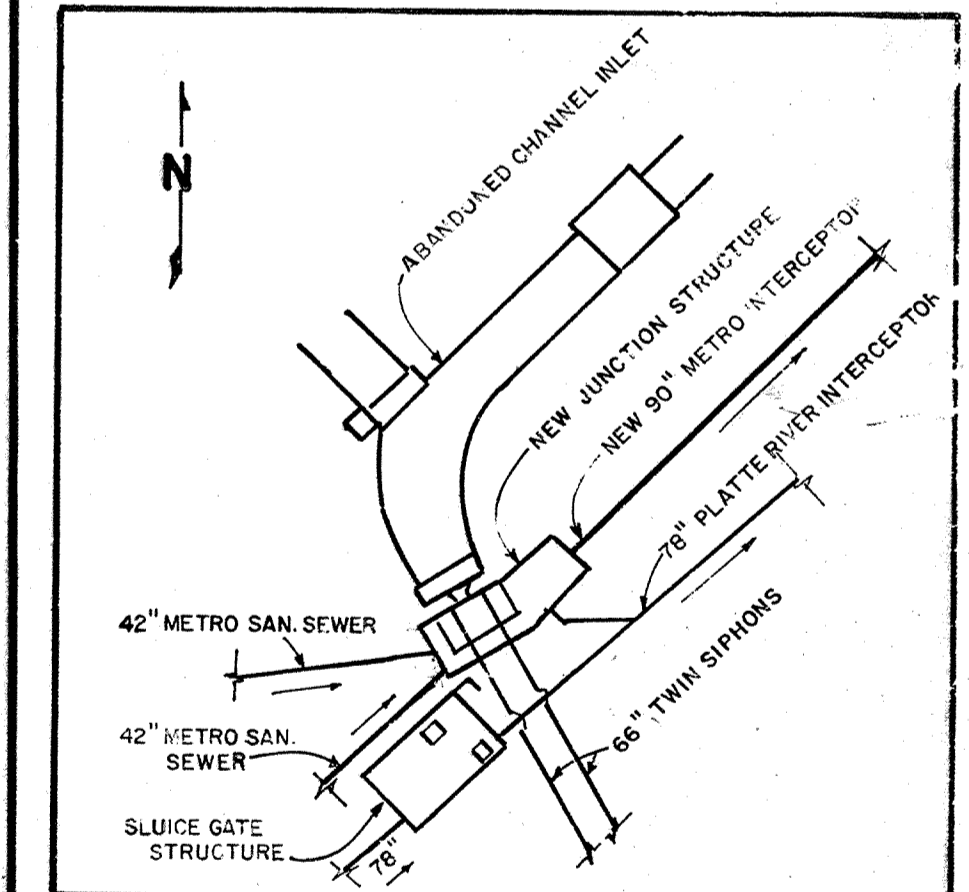

DETAIL DRAWING OF NEW JUNCTION
 STRUCTURE (METRO)

NOT: METRO GLOBEVILLE INTERCEPTOR WAS POSTED FROM "AS
 DESIGNED" DRAWING FOR ACCURATE INFORMATION,
 REFER TO "AS BUILT" DRAWING.

Abandoned - 21588' 18" in Downing / 52nd to 55th AVE - B-12-87 - RM
 Abandoned - 186.23' 10" in Downing / 52nd to 57th AVE - B-12-87 - RM
 Abandoned - 584' 8" in 52nd AVE - From Emerson to Downing
 Abandoned - 1418' 8" Sanitary between 51st & 52nd Ave
 in alleys between Emerson / Ogdan & Ogdan / Downing - Previously Rm
 Abandoned / 50th & Ogdan / 67th 21" SANITARY - 812-87 - RM
 Abandoned / 50th & Ogdan / 730' 18" SANITARY - 812-87 - RM
 ABANDONED - 50th WASHINGTON - 5/15/85

CITY AND COUNTY OF DENVER
 DEPARTMENT OF PUBLIC WORKS
 WASTEWATER MANAGEMENT DIVISION
 S.W.1/4, SEC. 14, T. 3 S., R. 68 W.
 QUAD MAP NO. N.E. 68
 ORIGINAL SEWER BOOK NO. 26, PAGE 20

SANITARY

Original Date: Sept. 1, 1973
 Revision Date: 5/11/90 - RM
68-03-14.3

